


1963 Tinsack CA

LEGAL DESCRIPTION:
 MAP OF BRAINER
 ZONING:
GENERAL PLAN DESIGNATION:
PLANNING:
ADJACENT LOTS:
EXISTING RECORDS:
CURVE DATA:
SURVEYOR'S CERTIFICATE:

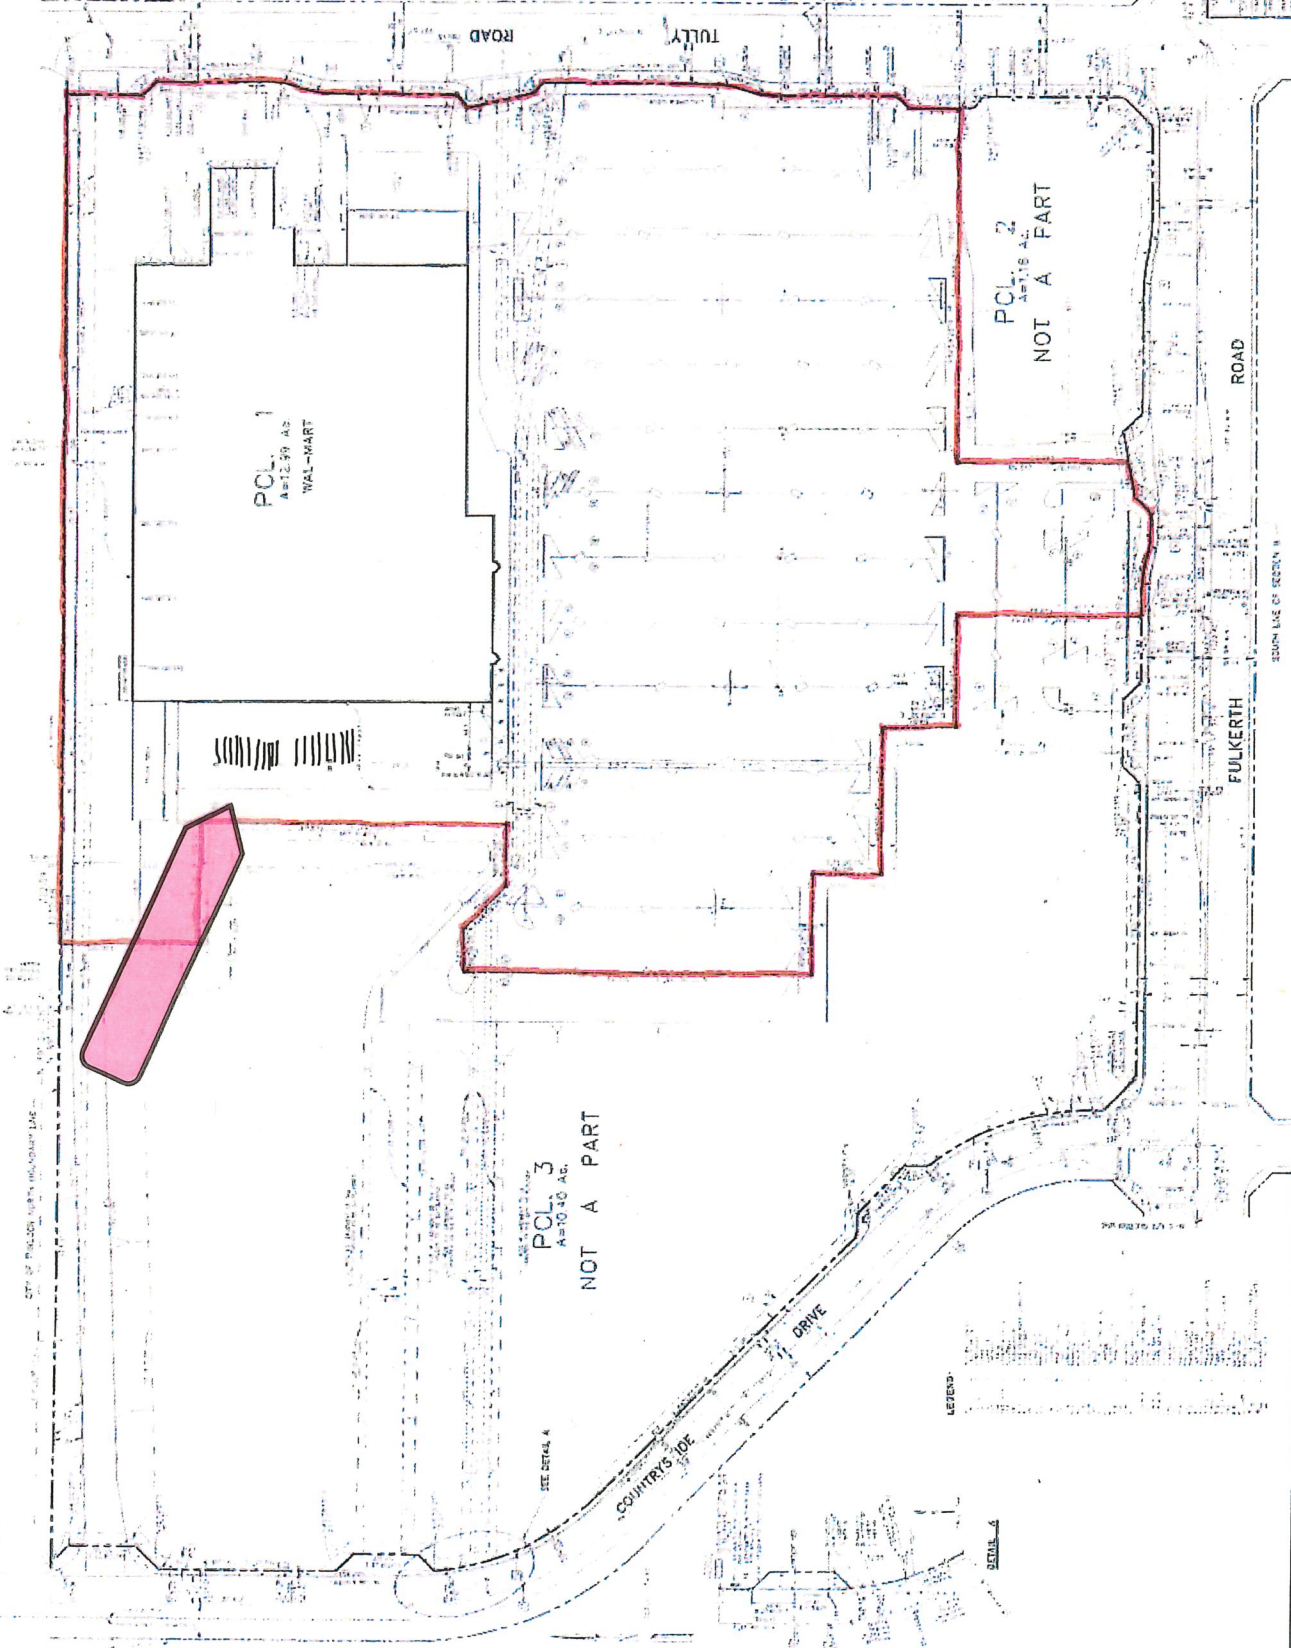

"AS-BUILT" A.L.T.A. SURVEY
 SECURITY ENGINEERING CO.
 10000 BAYVIEW DRIVE
 SAN DIEGO, CALIF. 92123
 DATE: 1/13/83